


T:\20-0521-01\PROJECT\CAD\DETAILS\COVER.dwg  
6/10/2020

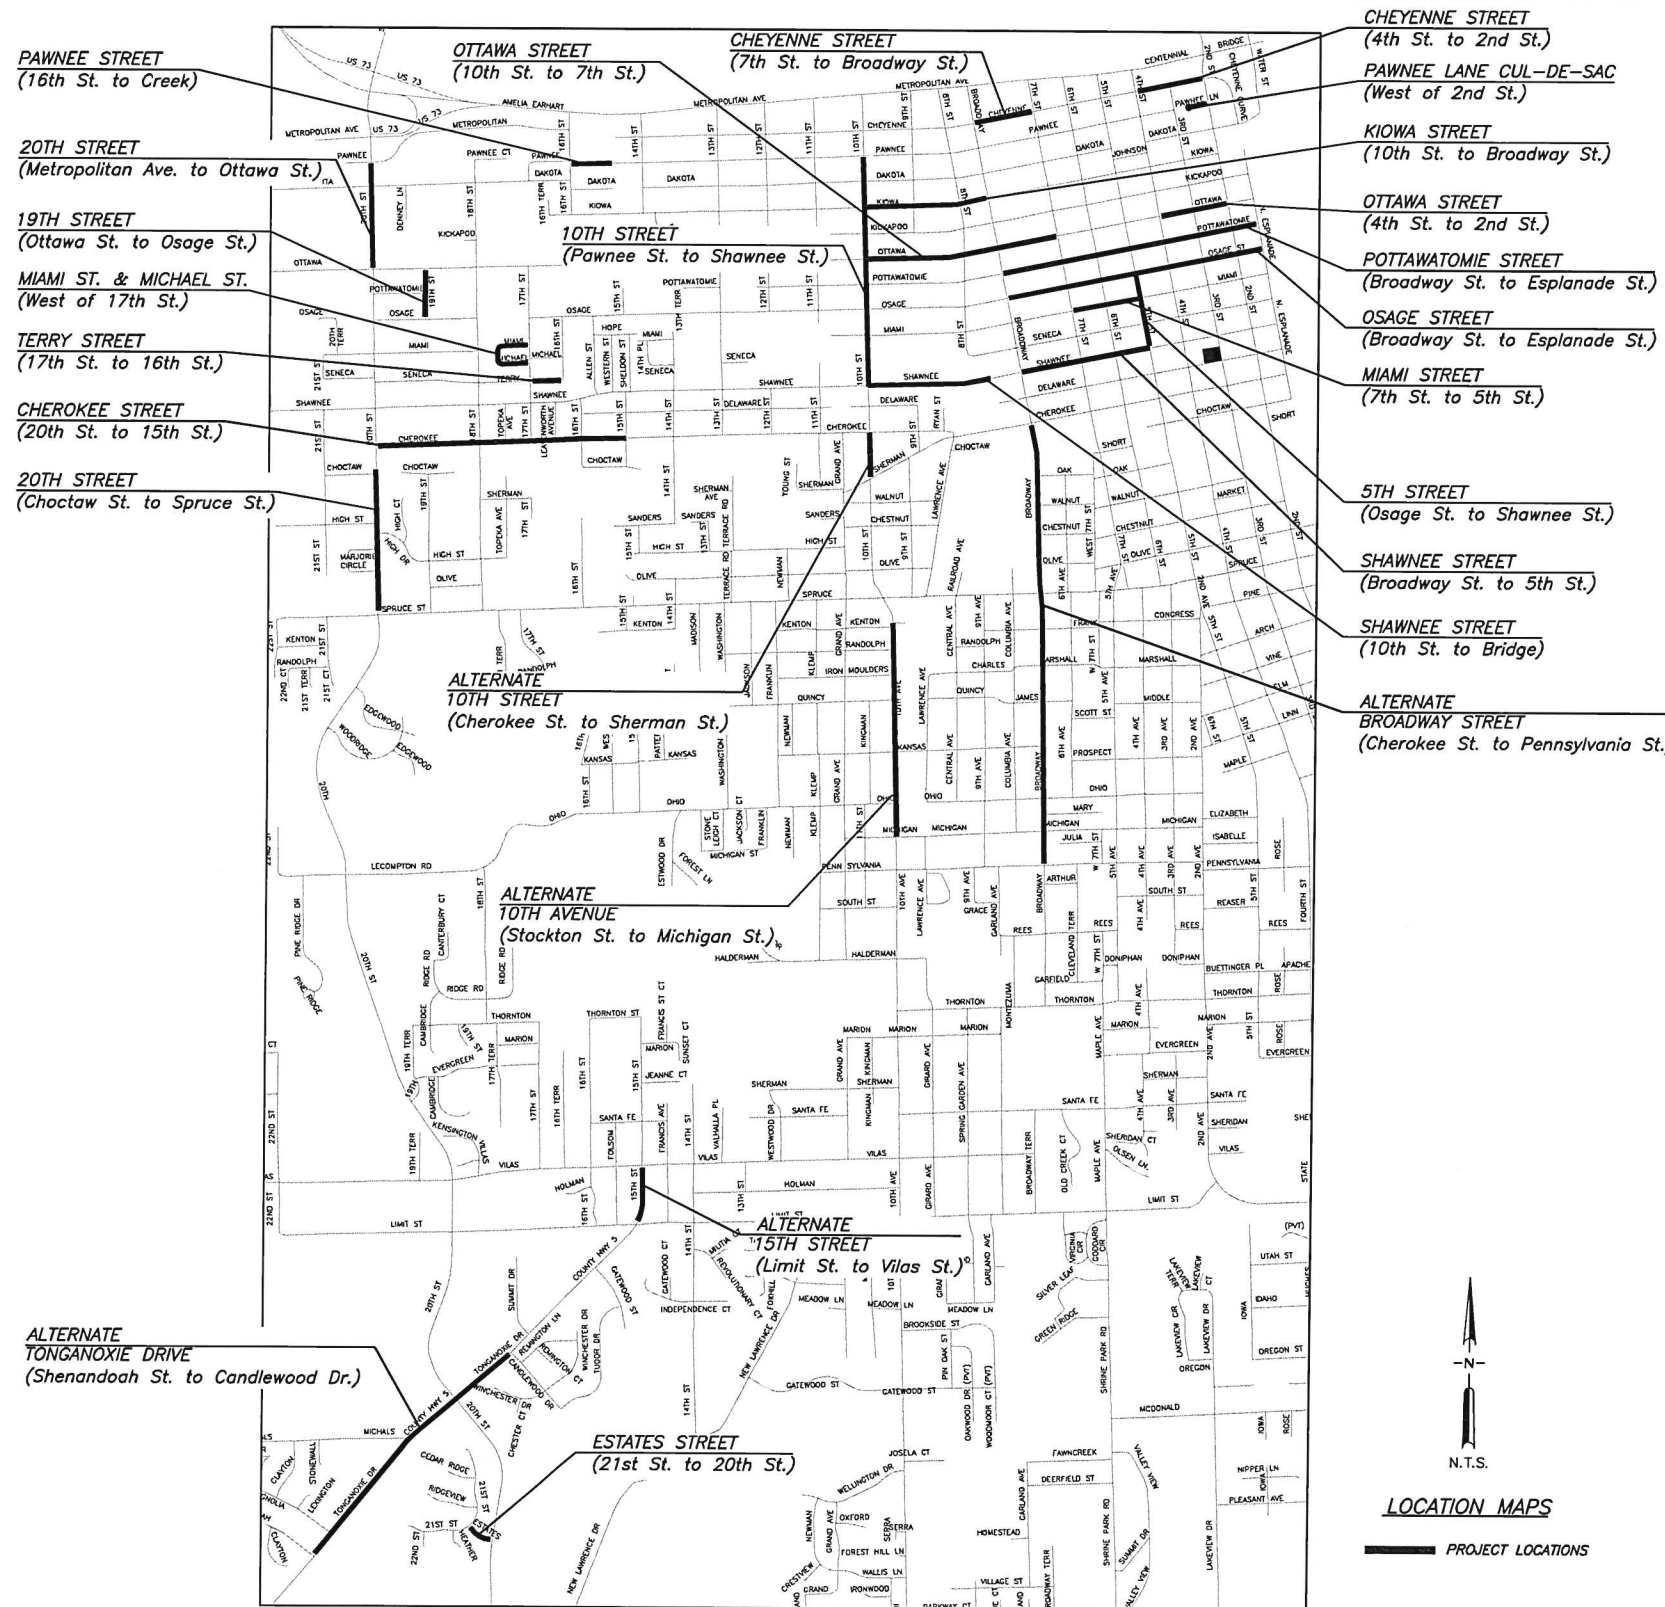


**MILL AND OVERLAY STREETS**

**INDEX OF SHEETS**

SHEET TITLE	PLAN
20TH STREET (Metropolitan Ave. to Ottawa St.)	15
PAWNEE STREET (16th St. to Creek)	16
19TH STREET (Ottawa St. to Osage St.)	17
MIAMI ST. & MICHAEL ST. (West of 17th St.)	18
TERRY STREET (17th St. to 16th St.)	19
CHEROKEE STREET (20th St. to 15th St.)	20-21
20TH STREET (Choctaw St. to Spruce St.)	22
CHEYENNE STREET (7th St. to Broadway St.)	23
CHEYENNE STREET (4th St. to 2nd St.)	24
PAWNEE LANE CUL-DE-SAC (West of 2nd St.)	25
10TH STREET (Pawnee St. to Shawnee St.)	26-27
KIOWA STREET (10th St. to Broadway St.)	28
OTTAWA STREET (10th St. to 7th St.)	29
SHAWNEE STREET (10th St. to Bridge)	30
OTTAWA STREET (4th St. to 2nd St.)	31
POTTAWATOMIE STREET (Broadway St. to Esplanade St.)	32-33
OSAGE STREET (Broadway St. to Esplanade St.)	34-35
5TH STREET (Osage St. to Shawnee St.)	36
MIAMI STREET (7th St. to 5th St.)	37
SHAWNEE STREET (Broadway St. to 5th St.)	38
ESTATES STREET (21st St. to 20th St.)	39
<b>ALTERNATES</b>	
<del>10TH STREET (Cherokee St. to Sherman St.)</del>	40
<del>10TH AVENUE (Stockton St. to Michigan St.)</del>	41
<del>BROADWAY STREET (Cherokee St. to Pennsylvania St.)</del>	42-44
<del>15TH STREET (Limit St. to Vilas St.)</del>	45
TONGANOXIE DRIVE (Shenandoah St. to Candlewood Dr.)	46-47

Not doing Alternates that have a line through them, only doing Tonganoxie Drive.

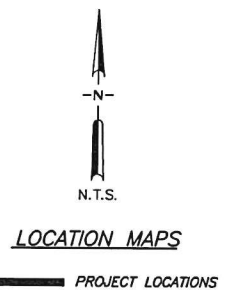

<p>Drawn: Checked: Approved: JMS CAF KEC</p>	<p>Noted: 5-5-20 PRELIMINARY PLANS</p>
<p>7101 West 128th Street, Suite 110 Ovland Park, Kansas 66213 Phone: 913-239-1100 Toll Free: 877-527-5468 Fax: 913-239-1111 www.affinis.com</p>	
<p><b>Affinis</b> CORP ENGINEERS • PLANNERS • CONSULTANTS</p>	
<p>CITY OF LEAVENWORTH, KANSAS 2020 PAVEMENT MANAGEMENT PROGRAM PROJECT NO. 2020-927 MILL AND OVERLAY STREETS LOCATION MAP</p>	
<p><b>14</b> 14 OF</p>	